


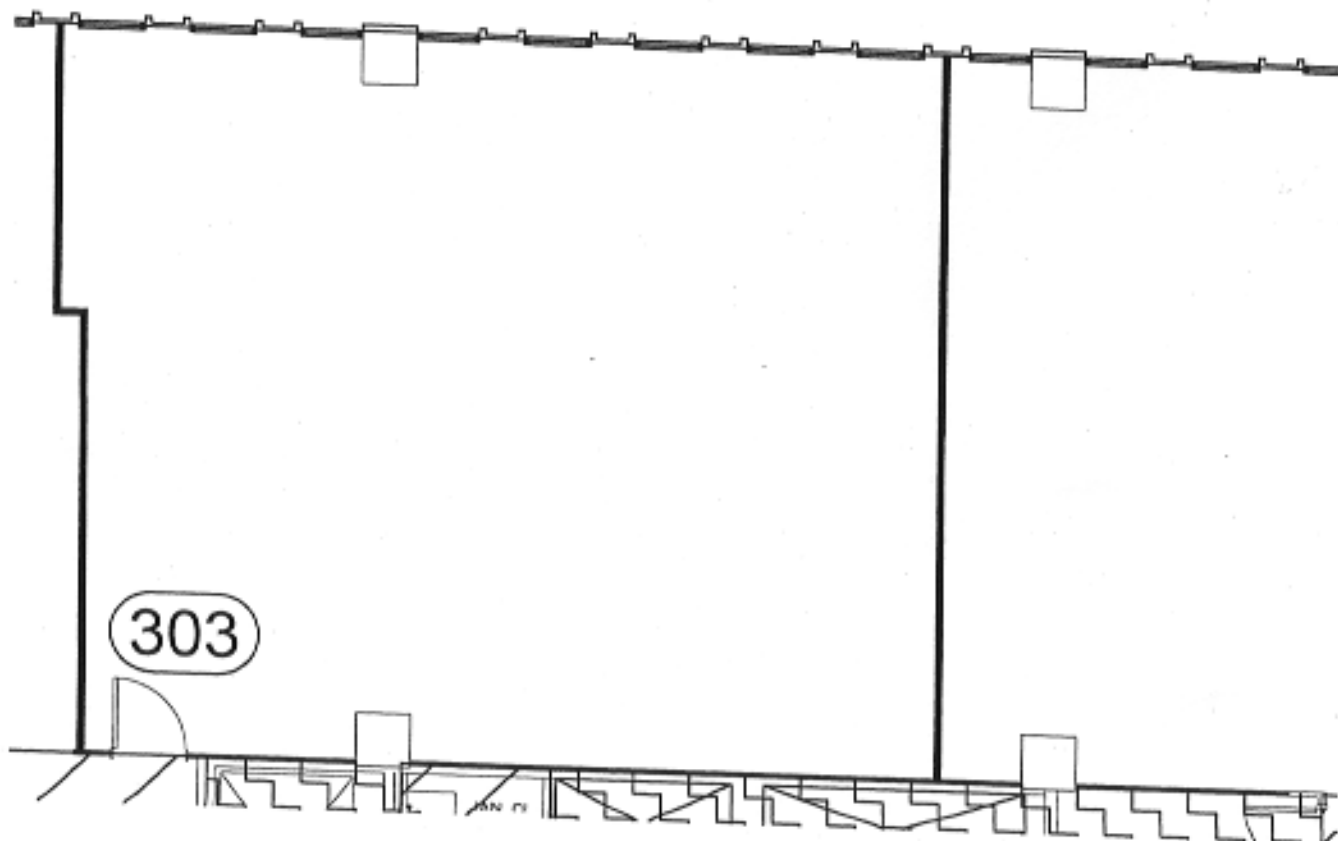

ELECTRICAL SYMBOLS LEGEND:

- DUPLEX CONVENIENCE RECEPTACLE
- 4 PLEX CONVENIENCE RECEPTACLE
- TELEPHONE RECEPTACLE
- DATA
- SWITCH
- ELECTRICAL PANEL

TENANT APPROVALS		
	DATE	SIGNATURE
FRAMING		
COMPLETION		

WALL TYPE LEGEND:

- DEMISING WALL BETWEEN UNITS
- UNIT INTERIOR WALL
- UNIT INTERIOR LOW WALL



Key Legend



SUITE LAYOUT
AS-BUILT
BRENTWOOD SQUARE

11661 San Vicente Blvd., Los Angeles, CA 90049

Date: 06-08-2013
 Scale: 1/8" = 1'-0"

SUITE #

303

TOTAL USABLE
 (APPROX) **1,126 SF**

TOTAL RENTABLE
 (APPROX) **1,329 SF**