


TENANT APPROVALS		
	DATE	SIGNATURE
FRAMING		
COMPLETION		

ELECTRICAL SYMBOLS LEGEND:

	DUPLEX CONVENIENCE RECEPTACLE
	4 PLEX CONVENIENCE RECEPTACLE
	TELEPHONE RECEPTACLE
	DATA
	SWITCH
	ELECTRICAL PANEL

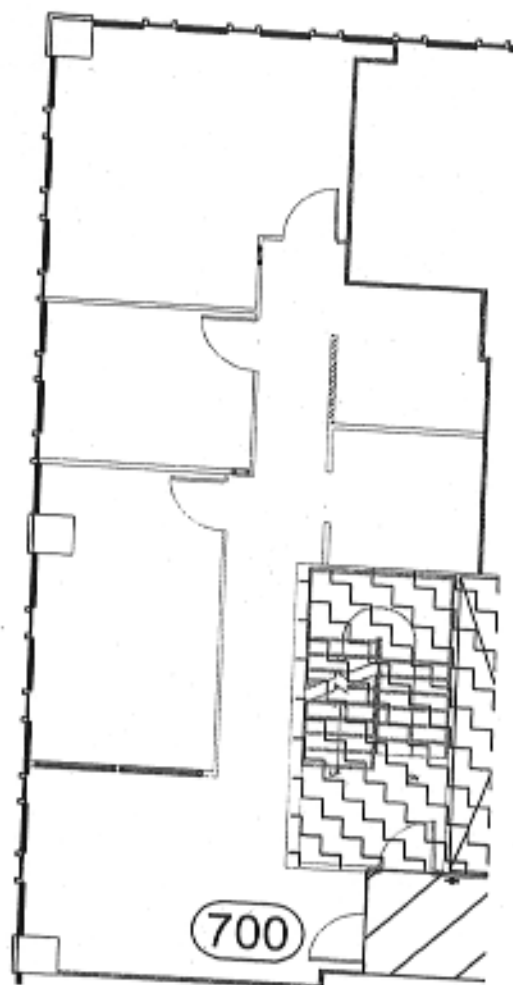

Key Legend



**SUITE LAYOUT
AS-BUILT**

BRENTWOOD SQUARE

11661 San Vicente Blvd., Los Angeles, CA 90049

Date: 04-17-2012
Scale: 3/32" = 1'-0"

SUITE #

700

TOTAL USABLE
(APPROX)

1,054 SF

TOTAL AREA
(APPROX)

1244 SF