



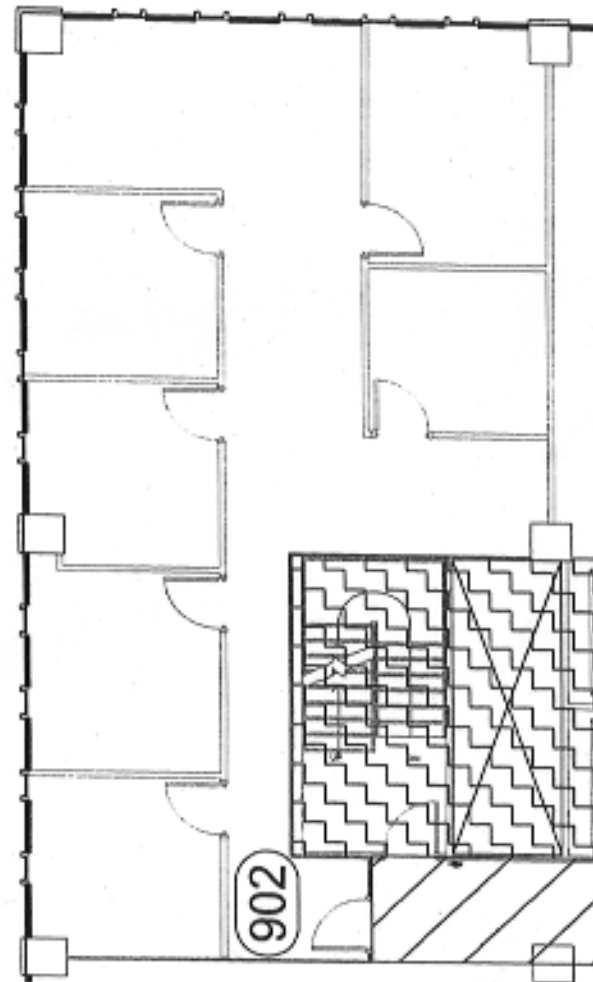

ELECTRICAL SYMBOLS LEGEND:

-  DUPLEX CONVENIENCE RECEPTACLE
-  4 PLEX CONVENIENCE RECEPTACLE
-  TELEPHONE RECEPTACLE
-  DATA
-  SWITCH
-  ELECTRICAL PANEL

TENANT APPROVALS		
	DATE	SIGNATURE
FRAMING		
COMPLETION		

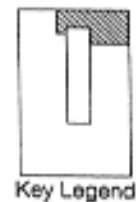

SUITE LAYOUT
AS-BUILT
BRENTWOOD SQUARE
 11661 San Vicente Blvd., Los Angeles, CA 90049

Date: 04-17-2012
 Scale: 3/32" = 1'-0"

SUITE #
902

TOTAL USABLE
 (APPROX) **1,289 SF**

TOTAL RENTABLE
 (APPROX) **1,521 SF**